



Illinois Department of Transportation Division of Water Resources

Mon. NBC 72

Report of Horizontal and Vertical control monuments-MNC

X coordinates : N/A NAD 83
 Y coordinates : N/A NAD 83
 Elevation : 682.94' NGVD 29

Azimuth To (Azimuth reference is North 0 degrees)


Monument or Object	Distance (ft.)	AZIMUTH
1. _____	_____	_____
2. _____	_____	_____
3. _____	_____	_____
4. _____	_____	_____

Location :

SW Cor of Dundee Rd (Rte 68) & Waukegan Rd (Rte 43)
30.46' SOUTH & of Rte 68 E
60.47' WEST & of Rte 43 E

Nearest Town North BrookRange R 12 ETownship T 42 NSection 10

Recovery Tie Sketch

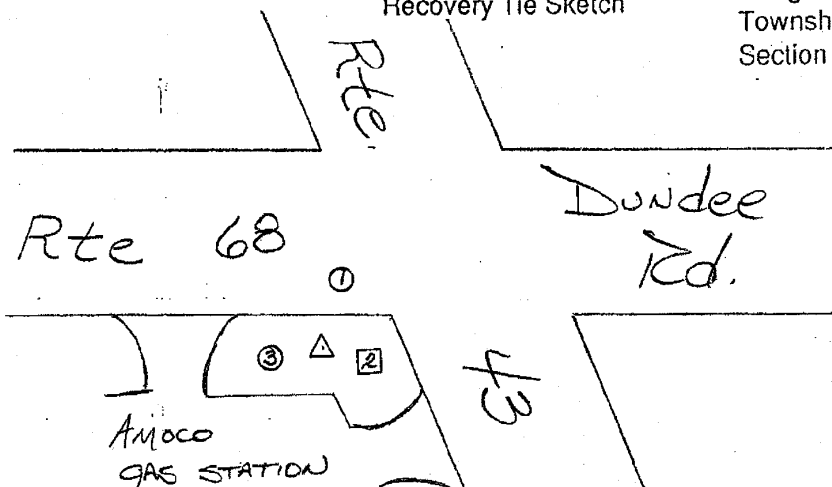

Rm #1 CHIS "X" ON M.H. RIM 9.22
 Rm #2 CHIS "X" ON N.W. CORNER HAND HOLE 9.12
 Rm #3 CHIS "X" ON N.E CORNER TRAFFIC SIGNAL BASE 4.44
 Rm #4 _____