



# Illinois Department of Transportation Division of Water Resources

Mon. NBC 75

## Report of Horizontal and Vertical control monuments-MNC

X coordinates : N/A NAD 83  
 Y coordinates : N/A NAD 83  
 Elevation : 662.72' NGVD 29


Azimuth To (Azimuth reference is North 0 degrees)

| Monument or Object | Distance (ft.) | AZIMUTH |
|--------------------|----------------|---------|
| 1. _____           | _____          | _____   |
| 2. _____           | _____          | _____   |
| 3. _____           | _____          | _____   |
| 4. _____           | _____          | _____   |

Location : West Side of Lee Rd Appx 9.5' of Grant Rd  
Appx 9.4m South of Dundee (Rte 68)  
18.9' WEST OF E LEE Rd

Nearest Town North Brook  
 Range R12E  
 Township T43N  
 Section 11

Recovery Tie Sketch

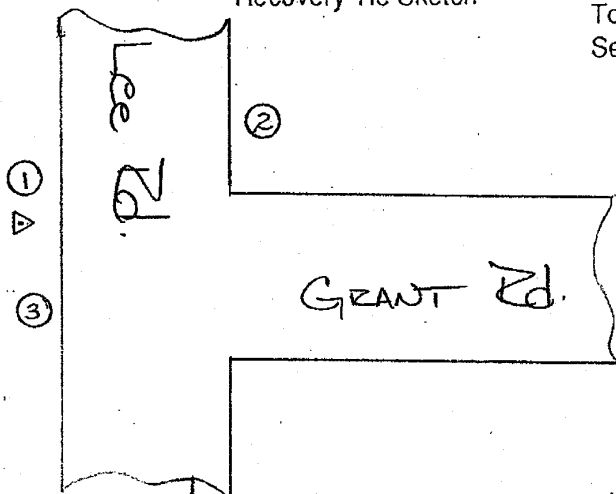

Rm #1 CHIS "X" ON N. HOLE RIM / 4.94  
 Rm #2 NAIL/WASHER IN POWER POLE / LIGHT 57.51  
 Rm #3 CHIS "X" ON N. HOLE RIM 16.09  
 Rm #4