



Illinois Department of Transportation Division of Water Resources

 Mon. NBC 76

Report of Horizontal and Vertical control monuments-MNC

X coordinates : N/A
 Y coordinates : N/A
 Elevation : 641.04'

NAD 83
 NAD 83
 NGVD 29

Azimuth To (Azimuth reference is North 0 degrees)

Monument or Object	Distance (ft.)	AZIMUTH
1. _____	_____	_____
2. _____	_____	_____
3. _____	_____	_____
4. _____	_____	_____



Location :

SE Corner of Sunset Ridge Rd & C&NW Railroad
Crossing To reach station from Rte 68 (Quince Rd.)
& Skokie Rd. Proceed South on Skokie 0.33 miles to
Sunset Ridge then follow Sunset Ridge 0.18 miles
to station on left.

 Nearest Town Northbrook

Range R12E
 Township T42N
 Section 12

Recovery Tie Sketch

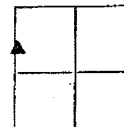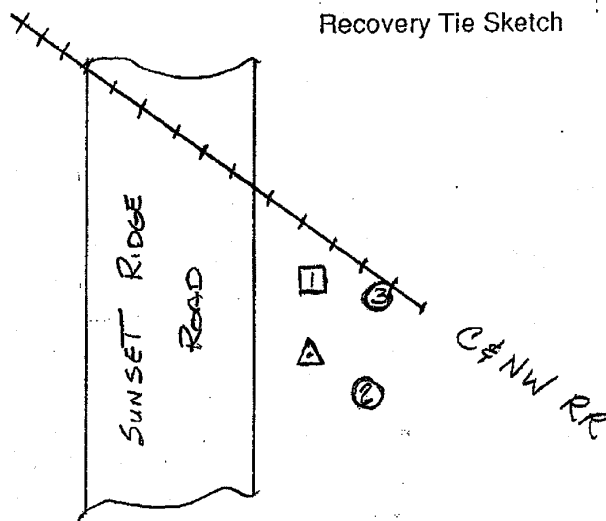

Rm #1	<u>CHIS "X" ON SW COR OF METAL BASE OF RR SIG LIGHT</u>	<u>16.53</u>
Rm #2	<u>NAIL & WASHER IN UTILITY POLE</u>	<u>10.12</u>
Rm #3	<u>" " RR TIE</u>	<u>16.06</u>
Rm #4	<u>E OF SUNSET RIDGE RD</u>	<u>15.90</u>